



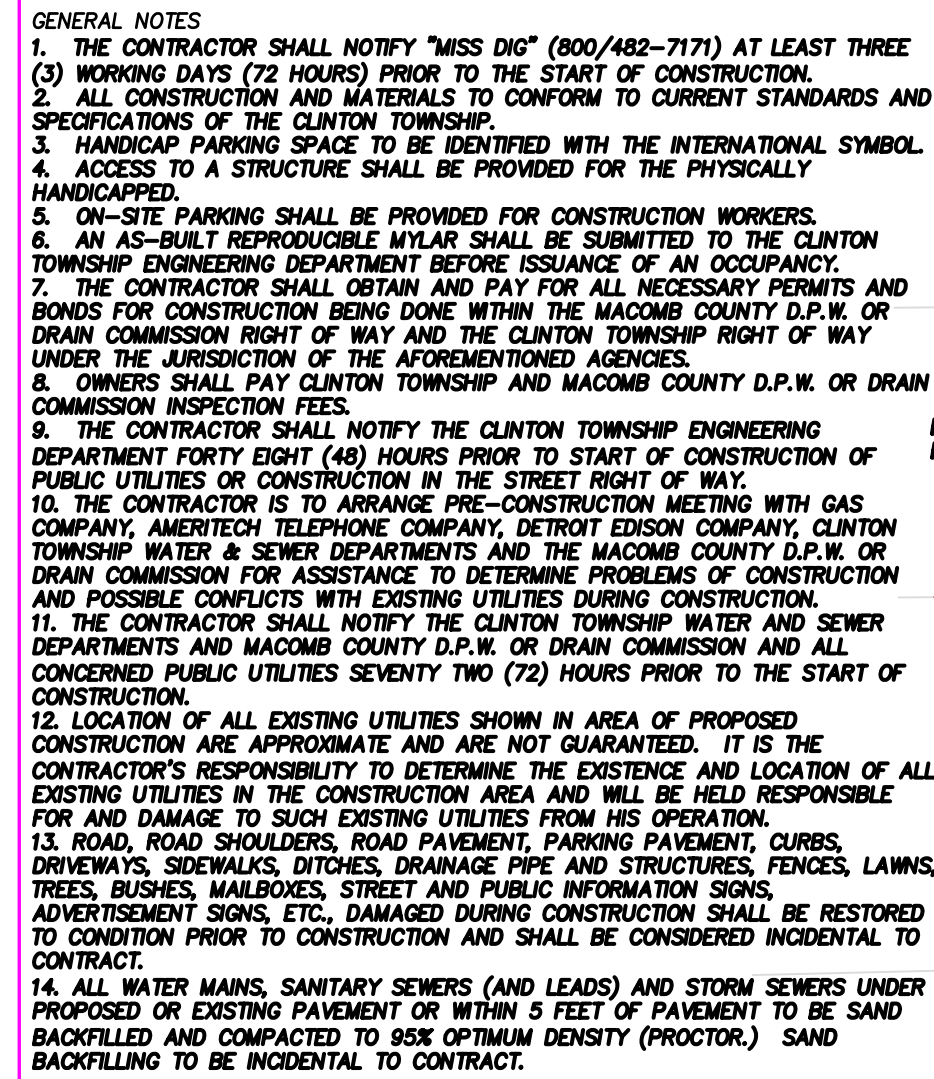

LEGAL DESCRIPTION (SUPPLIED BY CLIENT):
50-11-03-105-001 D 10 89 SUB 98CR ENTERPRISE INDUSTRIAL
THAT PART TAKEN FOR MDOT HALL RD. WIDENING DESC. AS:
SD LOT 10: TH N 87°46'13" E 350.74 FT. TO THE NE COR. OF
01°16'00" E 37.38 FT; TH 351.65 FT ALG THE ARC OF A CURVE
OF CURVE 03°30'59" RADIUS = 5729.58 FT CONCAVE TO THE
87°07'23" W 351.60 FT; TH N 01°23'33" W 6.08 FT TO THE
DESC ABOVE CONTAIN 6,987 SQ FT. NET = 71,863 SQ FT OF

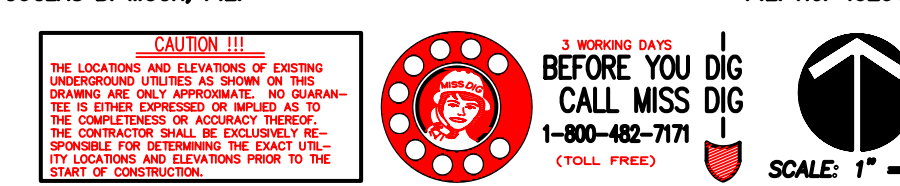

CAUTION!!!
 OPERATIONS AND ELEVATIONS OF EXISTING
 FOUNDATIONS ARE SHOWN ON THIS
 PLAN AND ARE ONLY APPROXIMATE AND GUARAN-
 TEES THERE EXPRESSED OR IMPLIED AS TO
 TRUTHFULNESS OR ACCURACY THEREOF.
 CONTRACTOR SHALL BE EXCLUSIVELY RE-
 SONSIBLE FOR DETERMINING THE EXACT U-
 TILITATIONS AND ELEVATIONS PRIOR TO THE
 CONSTRUCTION.

3 WORKING DAYS
BEFORE YOU DIG
 CALL MISS DIG
 1-800-482-7171
 (TOLL FREE)

SCALE: 1" = 20'

CLIENT
**RICHARD E. BURGETT
ODESSA BUILDERS, INC.**

45000 RIVER RIDGE DR., SUITE 200
CLINTON TWP., MI 48038

SHEET TITLE
DIMENSIONAL PLAN

SHEET NO.
CE-1
PROJECT NO.
02-0436

P.E. No. 49204



SCALE: 1" = 20'